


TORQUE ALL CONTROLLER TERMINAL SCREWS TO 80 IN LBS.

VARE TO BE COPPER WITH 60 DEGREE CELSIUS RADIUM INSULATION. TORQUE ALL TERMINAL BLOCK AND FUSE SCREWS TO 100 IN LBS.

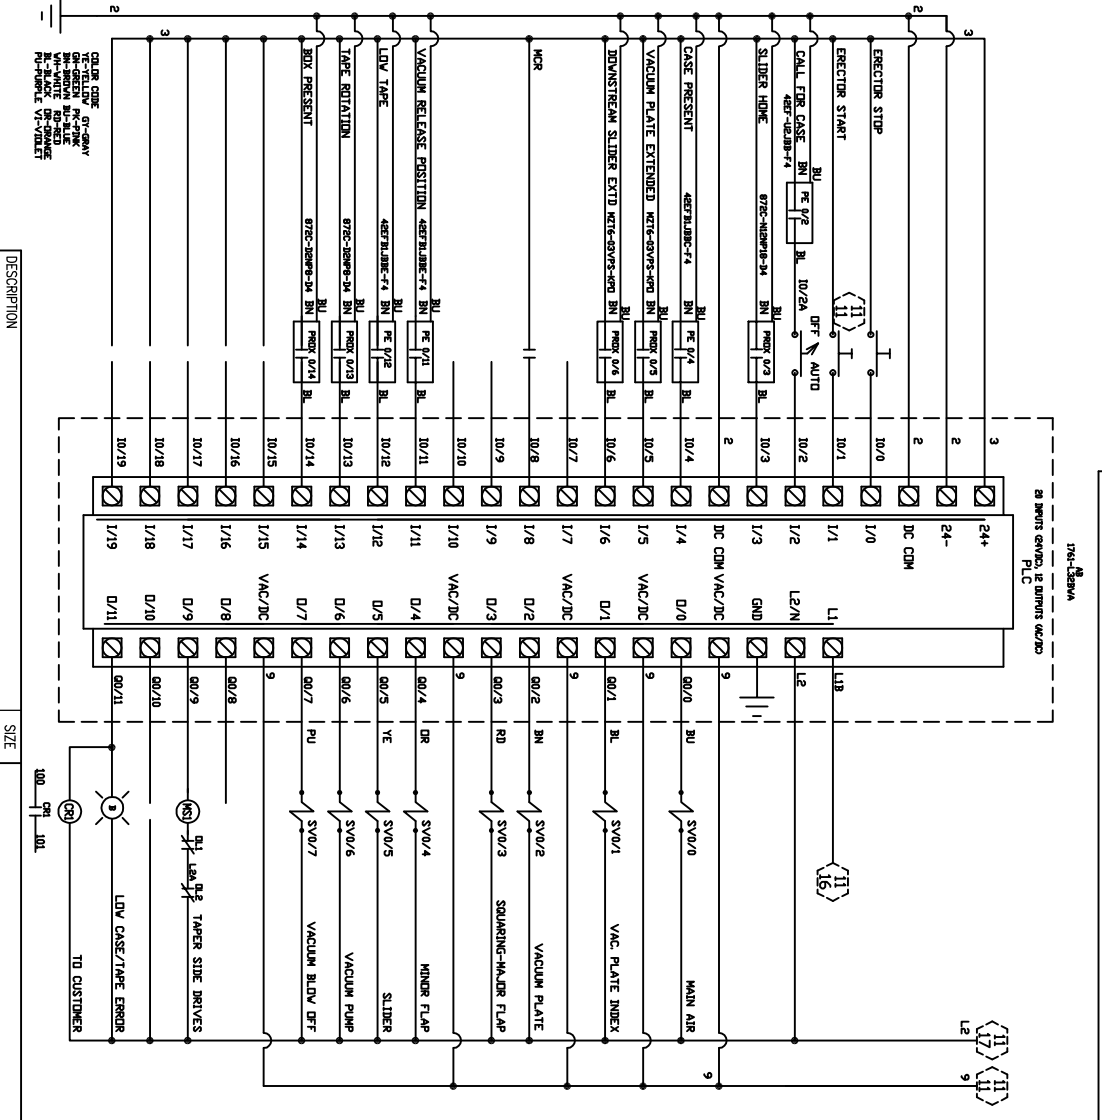


DATE: 02/06/07 REV. BY: 9858
 SHOP "AS BUILT".

DESCRIPTION: 2EZSB 120V DUAL DRIVE PIAB

NOTE: THIS DRAWING IS NOT TO BE REPRODUCED OR COPIED WITHOUT CONSENT FROM COMBI PACKAGING SYSTEMS

DRAWN BY: TMB
 CHECKED BY:
 DATE: 12/1/06
 DWT DATE:
 CHECK DATE:

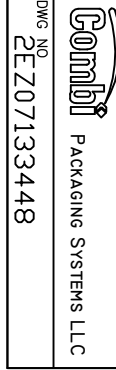

DWG NO. 2EZ07133448